


PROFILE OF DYKE LEFT BANK
SCALE
HORIZ. 1:1000 VERT. 1:100

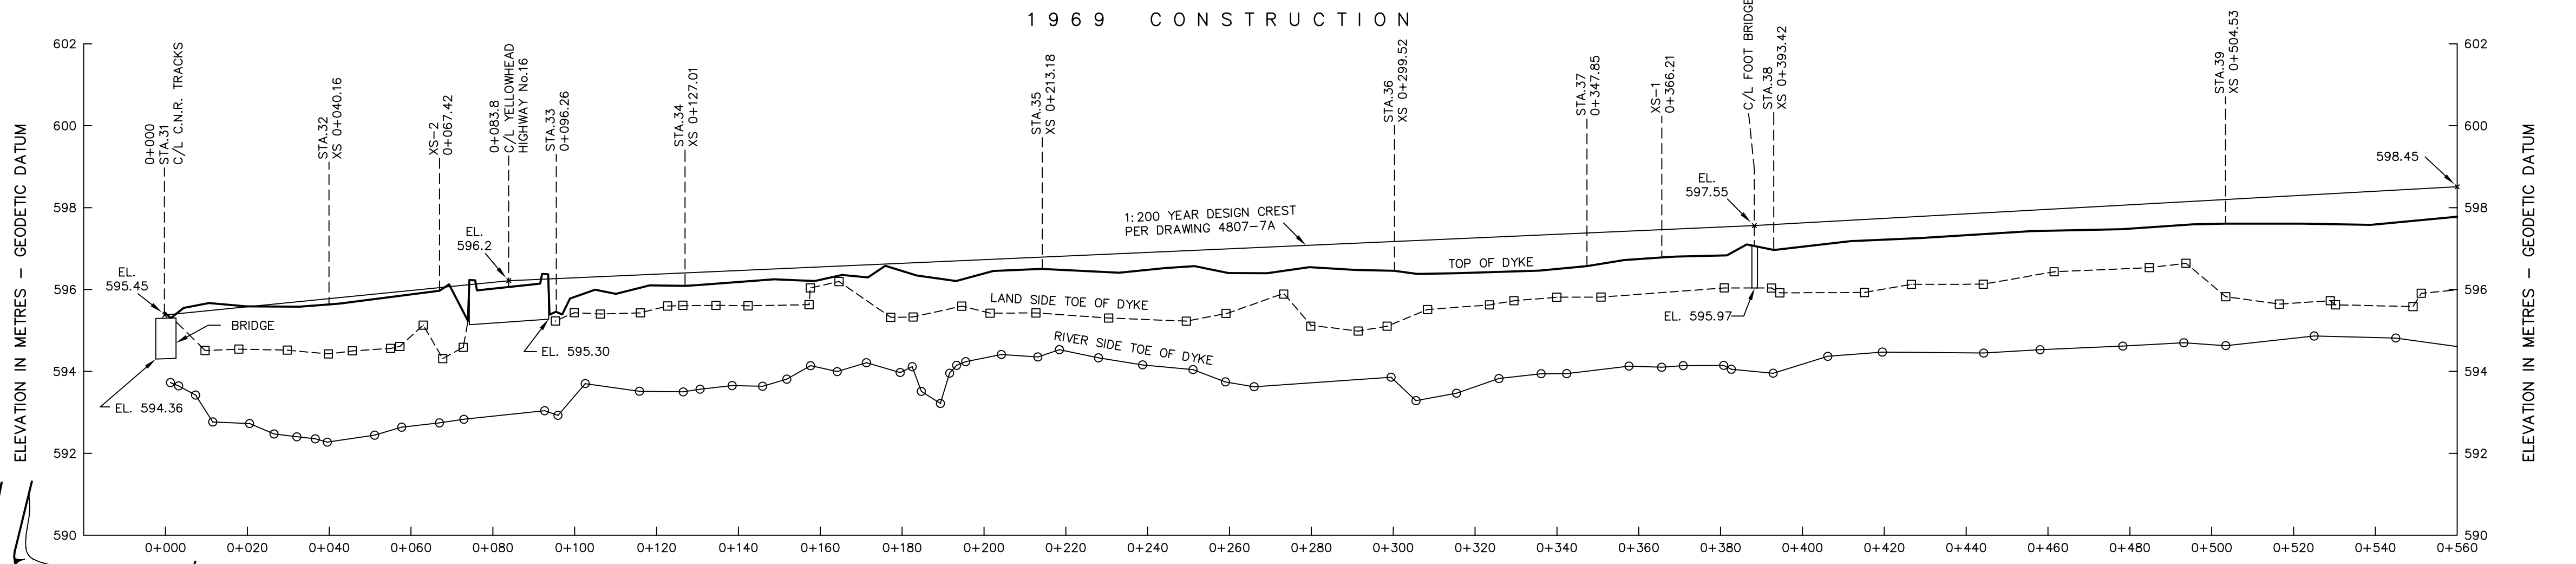

PROFILE OF DYKE RIGHT BANK
SCALE
HORIZ. 1:1000 VERT. 1:100

NOTE:
This information is considered historical as it represents channel conditions and configuration at the time of the survey only. User must accept responsibility of ensuring that the accuracy and completeness of provided data is suitable for the needs of the project or study. It is provided "as is" without warranty of any kind, whether express or implied. Under no circumstances will the Government of British Columbia be liable to any person or business entity for any direct, indirect, special, incidental, consequential, or other damages based on any use of this information.

- NOTES:**
- INDUSTRIAL AREA DYKE - PROJECT 79-2 SEE DRAWING 91-18-1 FOR NOTES.
 - BUCK CREEK LEFT BANK DYKE 1+364 - HWY. 16 TO 2+159 CONSTRUCTED 1969 (1+364 TO 1+910) CONSTRUCTED 1972/73 (1+910 TO 2+159) REFERENCE DRAWINGS 4807-2 AND 7A "BUCK CREEK IMPROVEMENTS" AS-CONSTRUCTED 1979.
 - BUCK CREEK RIGHT BANK DYKE 0+000 (CNR TRESTLE) TO 2+215 CONSTRUCTED 1969 (0+000 TO 0+800) CONSTRUCTED 1972/73 (0+800 TO 2+215) REFERENCE DRAWINGS 4807-2 AND 7A "BUCK CREEK IMPROVEMENTS" AS-CONSTRUCTED 1979.



PLAN
SCALE 1:1000

NOTES		LEGEND		STORAGE LICENCES		REFERENCES		REVISIONS		SURVEYED		Province of British Columbia		Ministry of Environment, Lands and Parks		FILE Nos.		
1) This plan has been prepared by the Ministry of Environment, Lands and Parks, Province of British Columbia.	2) SURVEY DATA: a) Field surveys were carried out by the Technical Support Section, Water Management Division in July 1990. b) Horizontal control was established by EDM traverse using a total station theodolite. c) Vertical control was established by differential leveling and by reciprocal height traversing using a total station theodolite. d) Cross sections, profiles and dyke details were obtained using a total station theodolite.	3) COORDINATES: a) B.C. Control Survey Post 74H2412 Northing: 6 031 508.537 Easting: 652 520.959 Elevation: 594.587 b) Water Survey of Canada (STA. OBEE013) BM1 Northing: 6 031 201.781 Easting: 652 785.964 Elevation: 598.734	□ TOE OF DYKE, LANDSIDE □ TOE OF DYKE, RIVERSIDE △ TOE OF RIVER BANK ● REFERENCE POINT + B.M. TEMPORARY BENCH MARK ○ TEMPORARY REFERENCE POINT o.p. CADASTRAL MARKER (e.g. Old Iron Pin) RIPRAP SWAMP	LICENCE	PRIORITY DATE	AUTHORIZED ACRE-FEET	DEVELOPED ACRE-FEET	DWG. No.	DESCRIPTION	DATE	No.	DESCRIPTION	DATE	M. PRONK DATE: JULY 1990	T. STEWART DATE: JULY 1991	APPROVED	DATE	SURVEY PROJECT No. 9028R026 NITS No. 93/77 Map Scale 1:50,000 SCALE 1:1000 NEGATIVE NO. DRAWING No. 91-18-2 TOTAL No. OF DWGS. 4