



PLAN

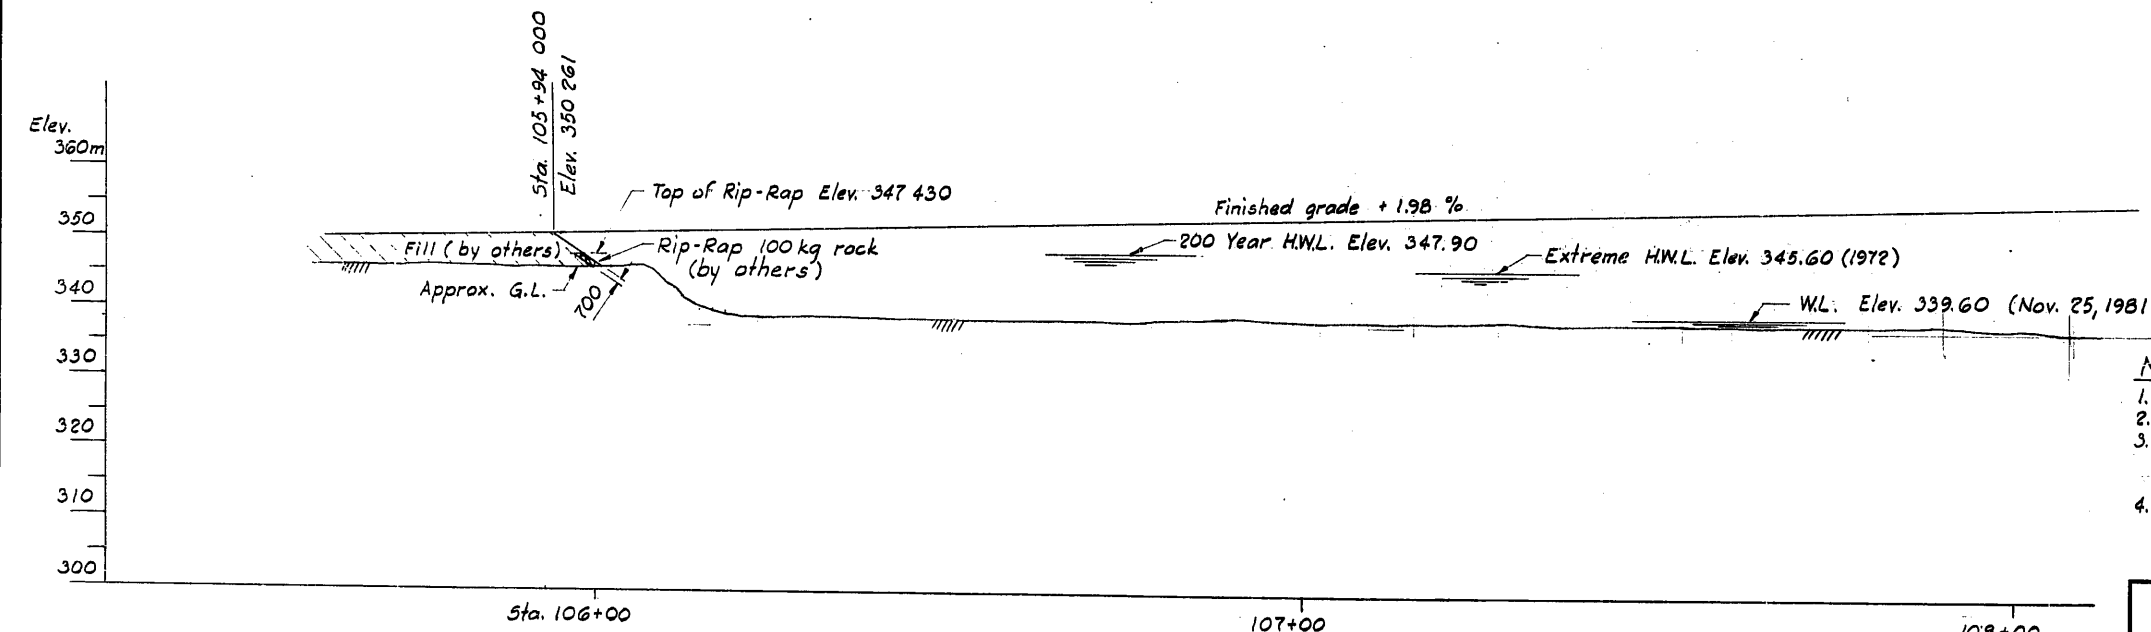

PROFILE
Scale 1:1 500

- LEGEND**
- S - Storm drains & sewers
 - San. - Sanitary sewers
 - W - Water main
 - G - Gas main
 - CP - Concrete pipe
 - AC - Asbestos cement pipe
 - IP - Iron pipe
 - CSP - Corrugated steel pipe
 - trans - transformer
 - L.S. - Lamp standard
 - B.H. - Borehole
 - O.R.L. - Office revision line

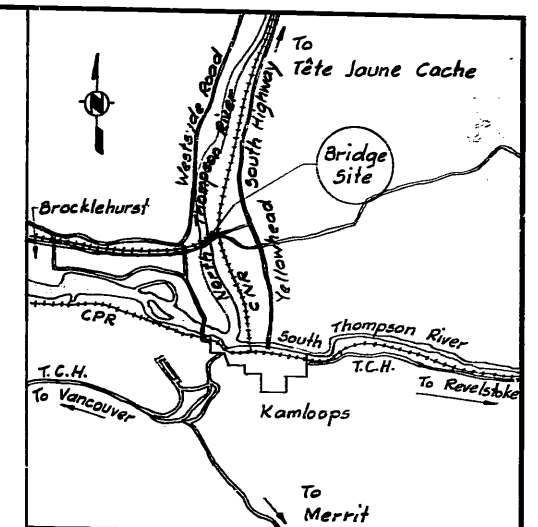

KEY MAP
Scale 1:126 720

LIST OF DRAWINGS	
Dwg. No	Title
2810-6	Site Plan - Sheet No 1
-7	Site Plan - Sheet No 2
-8	Boreholes - Sheet No 1
-9	Boreholes - Sheet No 2
-10	Boreholes - Sheet No 3
-11	General Arrangement-Sheet No 1
-12	General Arrangement-Sheet No 2
-13	Abutments
-14	Piers - Sheet No 1
-15	Piers - Sheet No 2
-16	Stringers
-17	Miscellaneous Steelwork
-18	Deck - Sheet No 1
-19	Deck - Sheet No 2
-20	Boreholes - Sheet No 4
-21	Boreholes - Sheet No 5
-22	Lighting Installation
-52	Pile Tip Elevations
-54	Deck - Sheet No 3
2784-1	Std. Bridge Parapet
-2	Std. Bridge Parapet - Transition
2785-1	Std. Br. Parapet - Steel Railing
2803-1	Std. Bridge Deck Joints

- NOTES:-**
- Survey by Highway Design and Survey (1981)
 - Datum: Geodetic
 - L.B.M. No 1 - Spike in 450 ft poplar tree about 23 000 Rt. of E of Highway at Sta. 109+10 000 Elev. 344.771.
 - For details of East Side see Dwg. No 2810-7



GOVERNMENT OF BRITISH COLUMBIA
MINISTRY OF TRANSPORTATION AND HIGHWAYS
BRIDGE ENGINEERING BRANCH

KAMLOOPS DISTRICT
HIGHWAY No 5 TO BROCKLEHURST
KAMLOOPS BRIDGE (NORTH THOMPSON RIVER)
SITE PLAN-SHEET No 1

D	As Built - No change	B.S.F. 06/28	PREPARED UNDER THE DIRECTION OF	DATE	SCALE: AS NOTED	NEG. No. 282955
	Dwg. No 32 and 34 added	M.C.M. 04/19		8/10/88	DRAWN G.W. 8/10/19	
	Dwg. No 22 added	M.C.M. 03/10		DATE	CHECKED N.G.D. DEC. 13 1982	
	REVISIONS			EXAMINED AND ACCEPTED	DATE	DRAWING No. 2810-6 C
			APPROVED FOR USE IN CONSTRUCTION		DATE 12.02.09	
			T.V.E. VICKERS SENIOR BRIDGE DESIGN ENGINEER		M.C.E. 15/83 EXECUTIVE DIRECTOR OF ENGINEERING	
			DIRECTOR OF BRIDGE ENGINEERING			

CANCEL PRINTS BEARING EARLIER LETTER