

NOTE:


This information is considered historical as it represents channel conditions and configuration at the time of the survey only. User must accept responsibility of ensuring that the accuracy and completeness of provided data is suitable for the needs of the project or study. It is provided "as is" without warranty of any kind, whether express or implied. Under no circumstances will the Government of British Columbia be liable to any person or business entity for any direct, indirect, special, incidental, consequential, or other damages based on any use of this information.

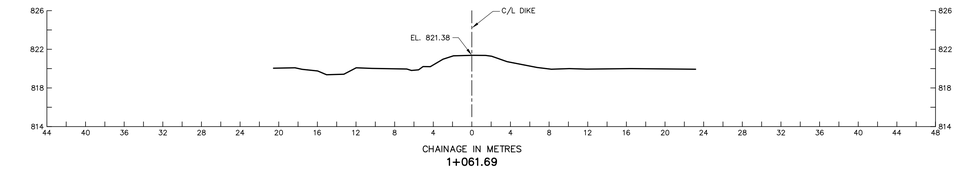


1+061.69

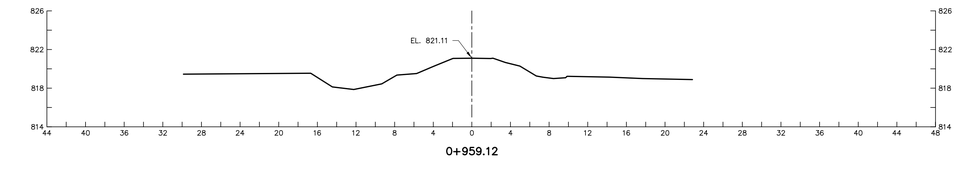


0+959.12

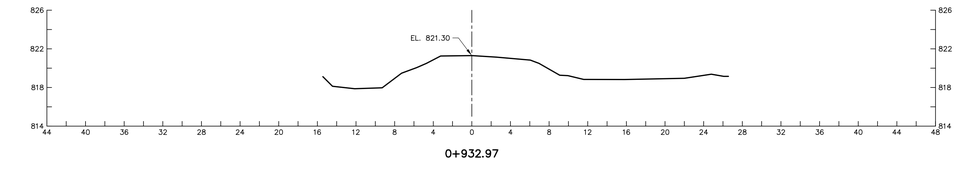


0+932.97

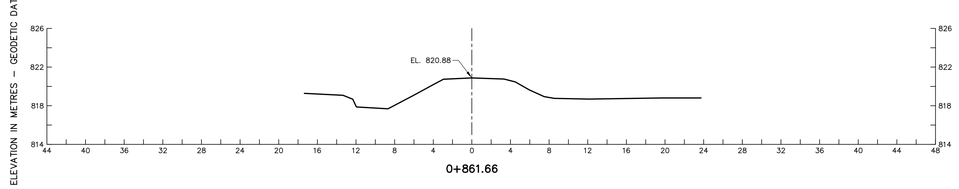


0+861.66

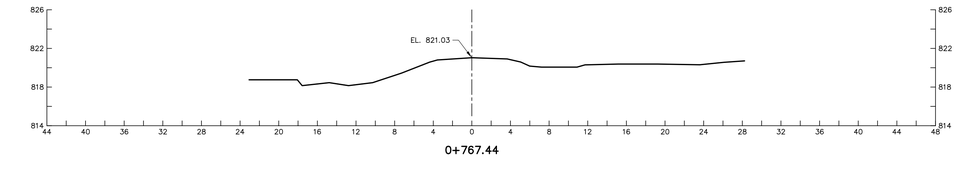


0+767.44

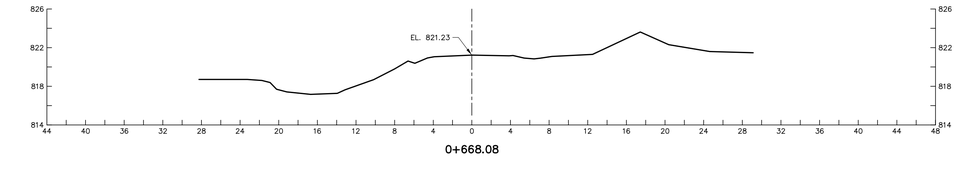


0+668.08

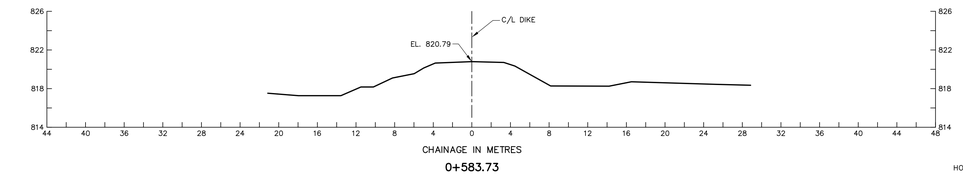


0+583.73

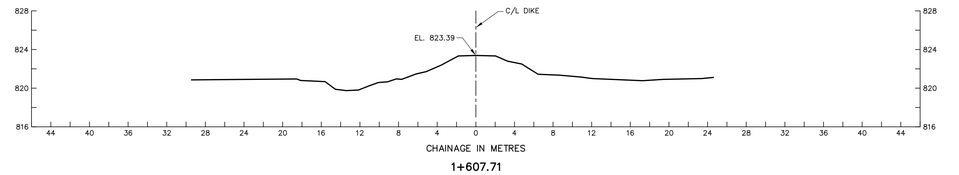


1+607.71

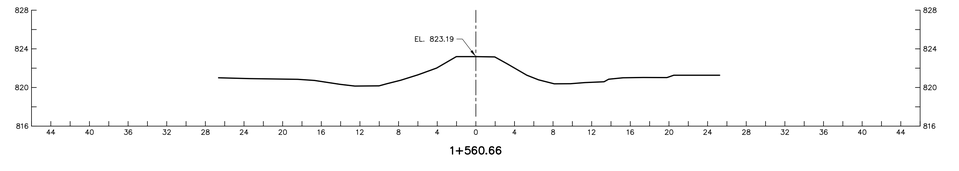


1+560.66

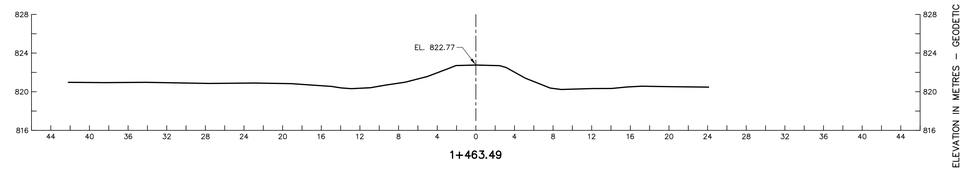


1+463.49

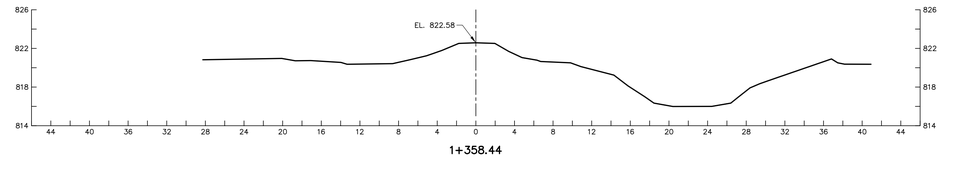

1+358.44

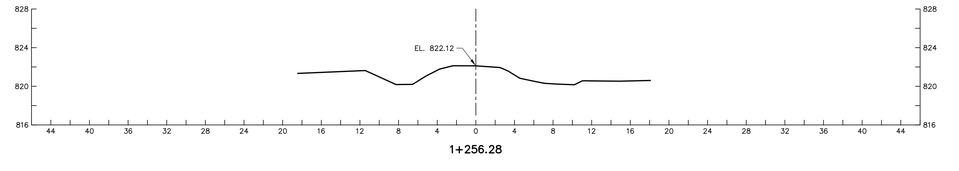

1+256.28

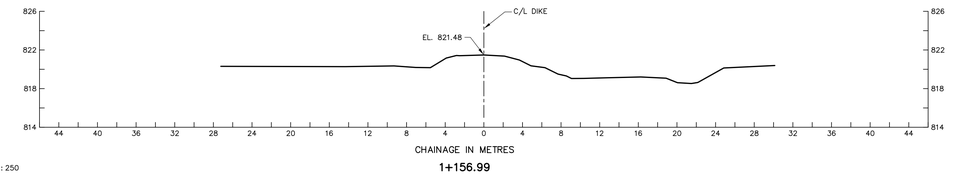

1+156.99

SCALE
HORIZ. 1: 250 VERT. 1: 250

NOTES	LEGEND

STORAGE LICENCES

LICENCE	PRIORITY DATE	AUTHORIZED ACRE-FEET	DEVELOPED ACRE-FEET

REFERENCES

DWG. No.	DESCRIPTION	DATE
99-3-1	PLAN AND PROFILE (AS CONSTRUCTED) DIKE	SEPT. 1999
99-3-2	PLAN AND PROFILE (AS CONSTRUCTED) DIKE	SEPT. 1999
99-3-3	(AS CONSTRUCTED) DIKE CROSS SECTIONS	SEPT. 1999

REVISIONS

No.	DESCRIPTION	DATE

SURVEYED M. PRONK
DATE JULY 1998
COMPILED B. EDWARD
CHECKED
DATE
DRAWN B. WOODS
APPROVED
DATE SEPT. 1999
ENGINEER

Province of British Columbia

Ministry of Environment, Lands and Parks
RESOURCES INVENTORY BRANCH
OPERATIONS SUB-SECTION

KOOTENAY RIVER AT CANAL FLATS

(AS CONSTRUCTED) DIKE CROSS SECTIONS

APPROVED Mike Pronk
HEAD, WATER SURVEYS UNIT, WATER INVENTORY SECTION
DATE NOV. 12, 1999

FILE Nos.
Branch
SURVEY PROJECT No. 98085008
NTS
Map No. 82J/4
Map Scale 1:50,000
SCALE AS SHOWN
DRAWING No. 99-3-4
TOTAL No. OF DWGS. 4

DDs