

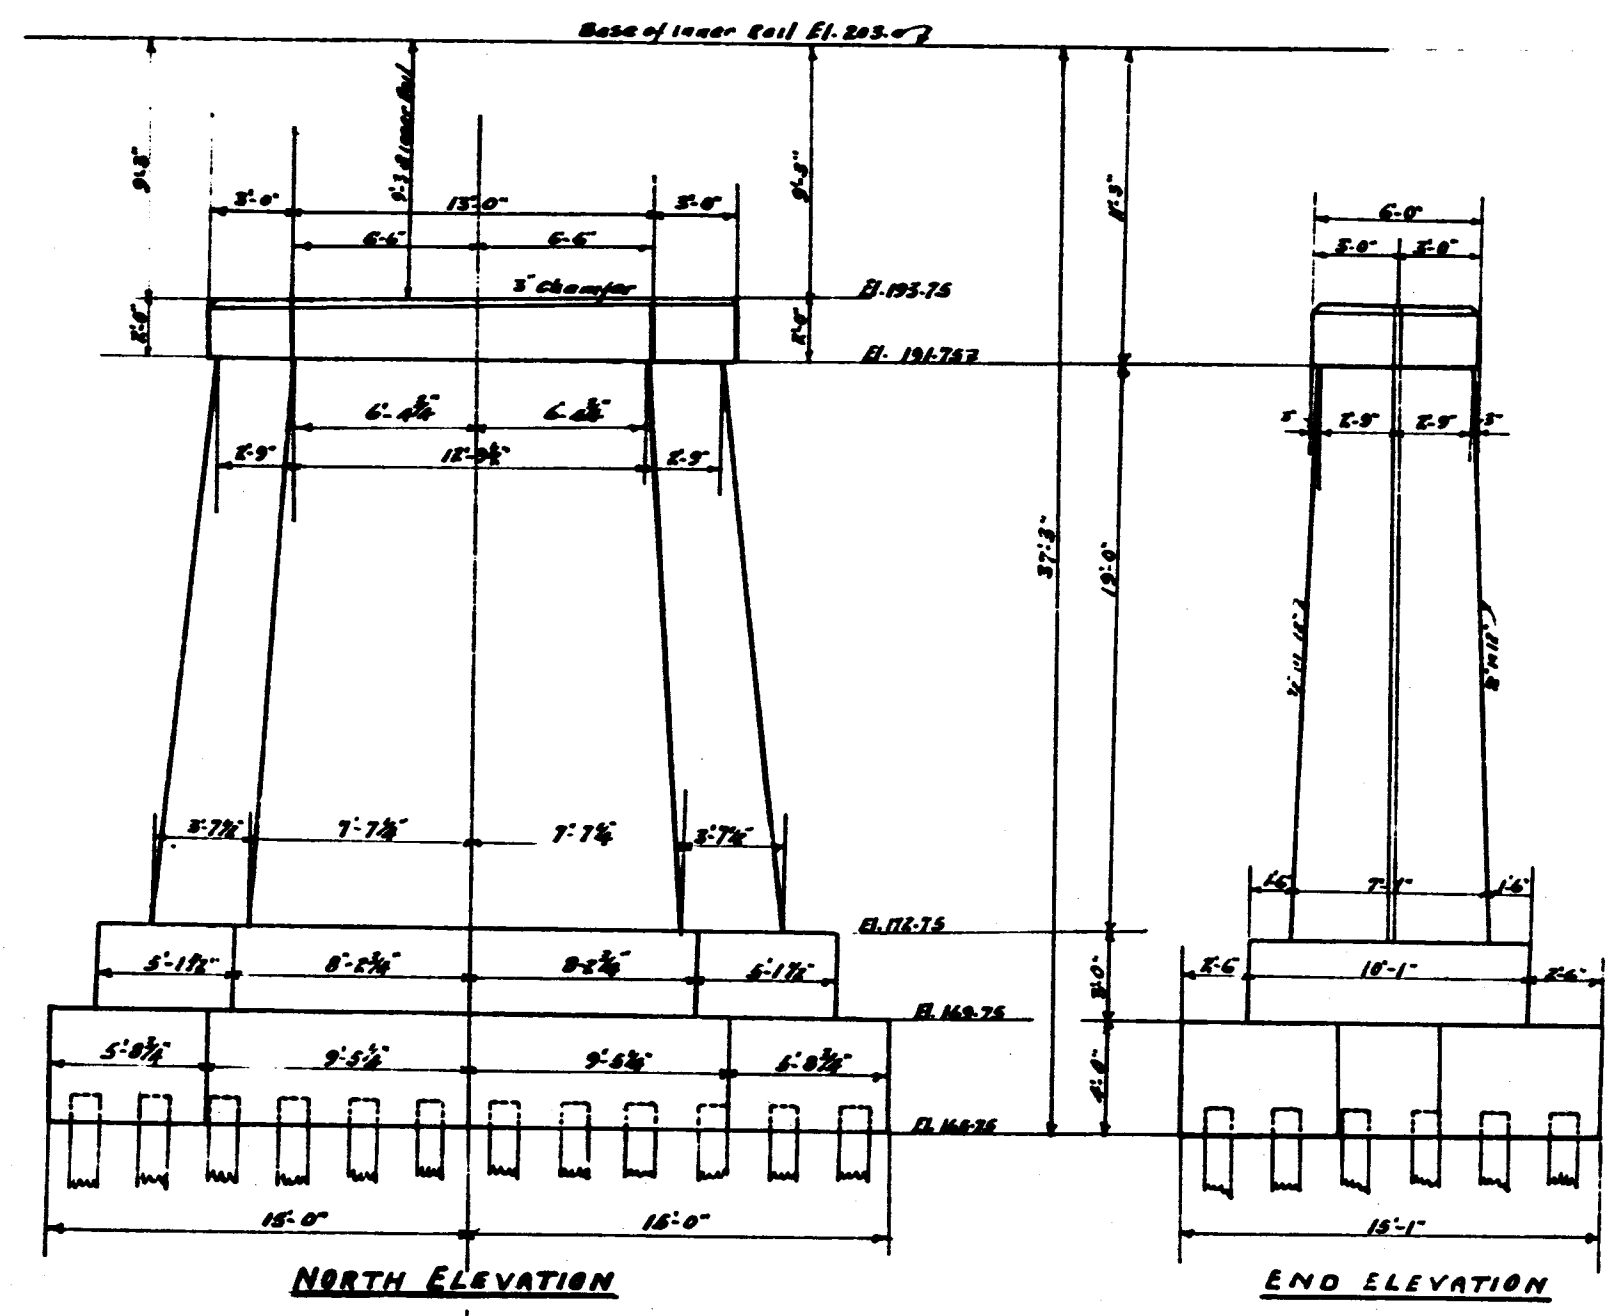


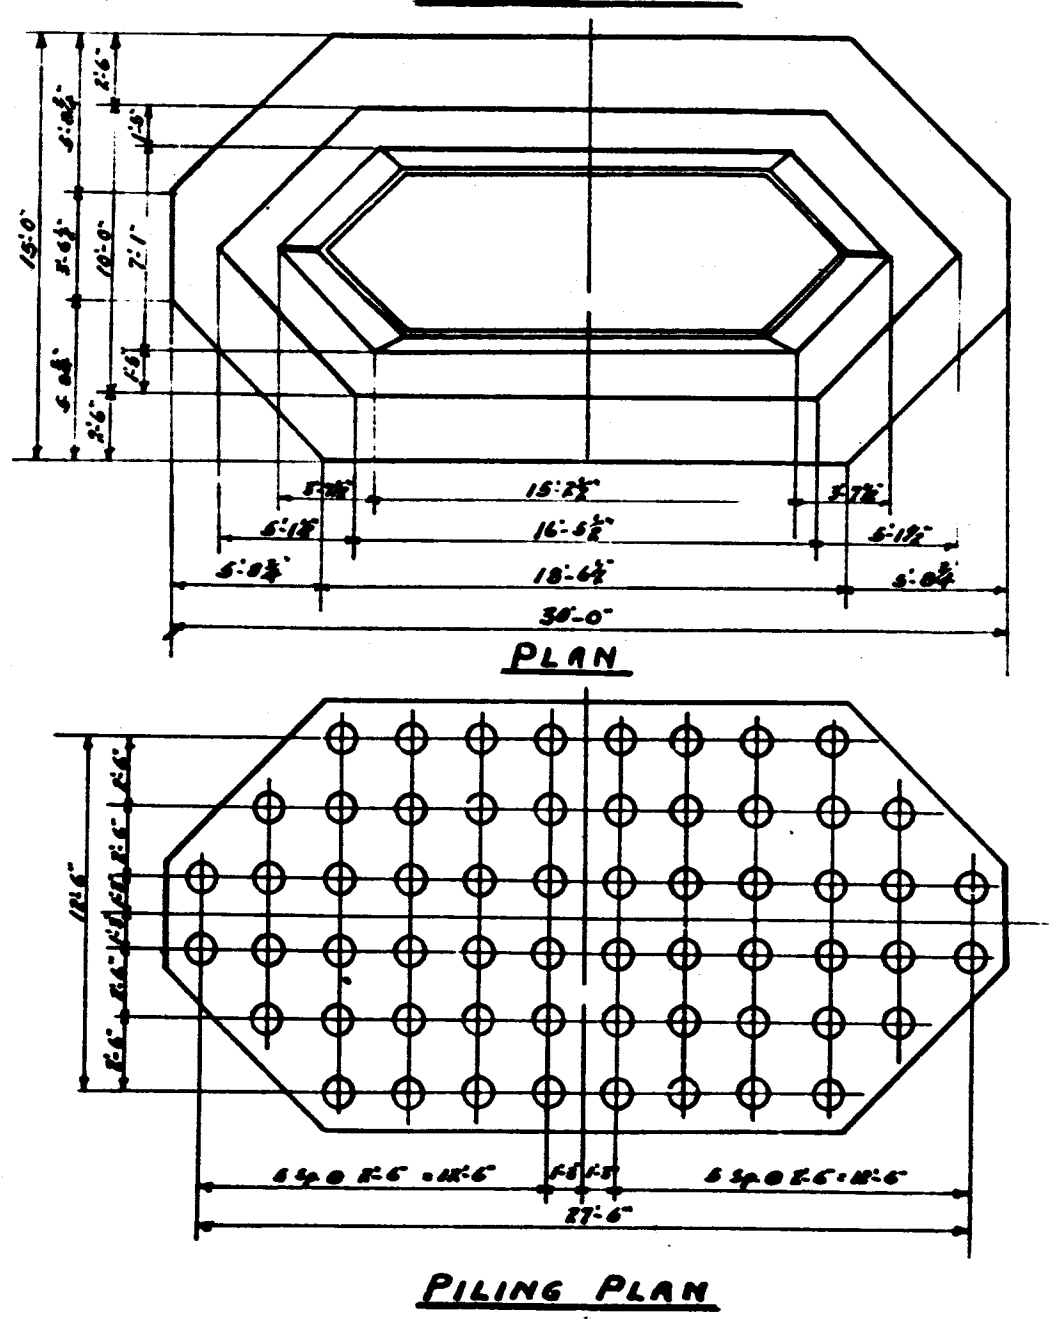



PIER Nº 1

CONCRETE 164 Cu.YDS

PILES 60

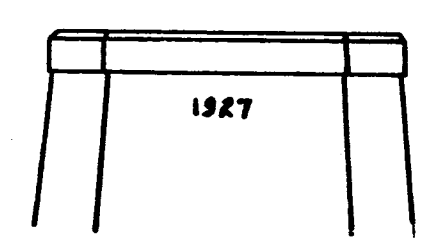

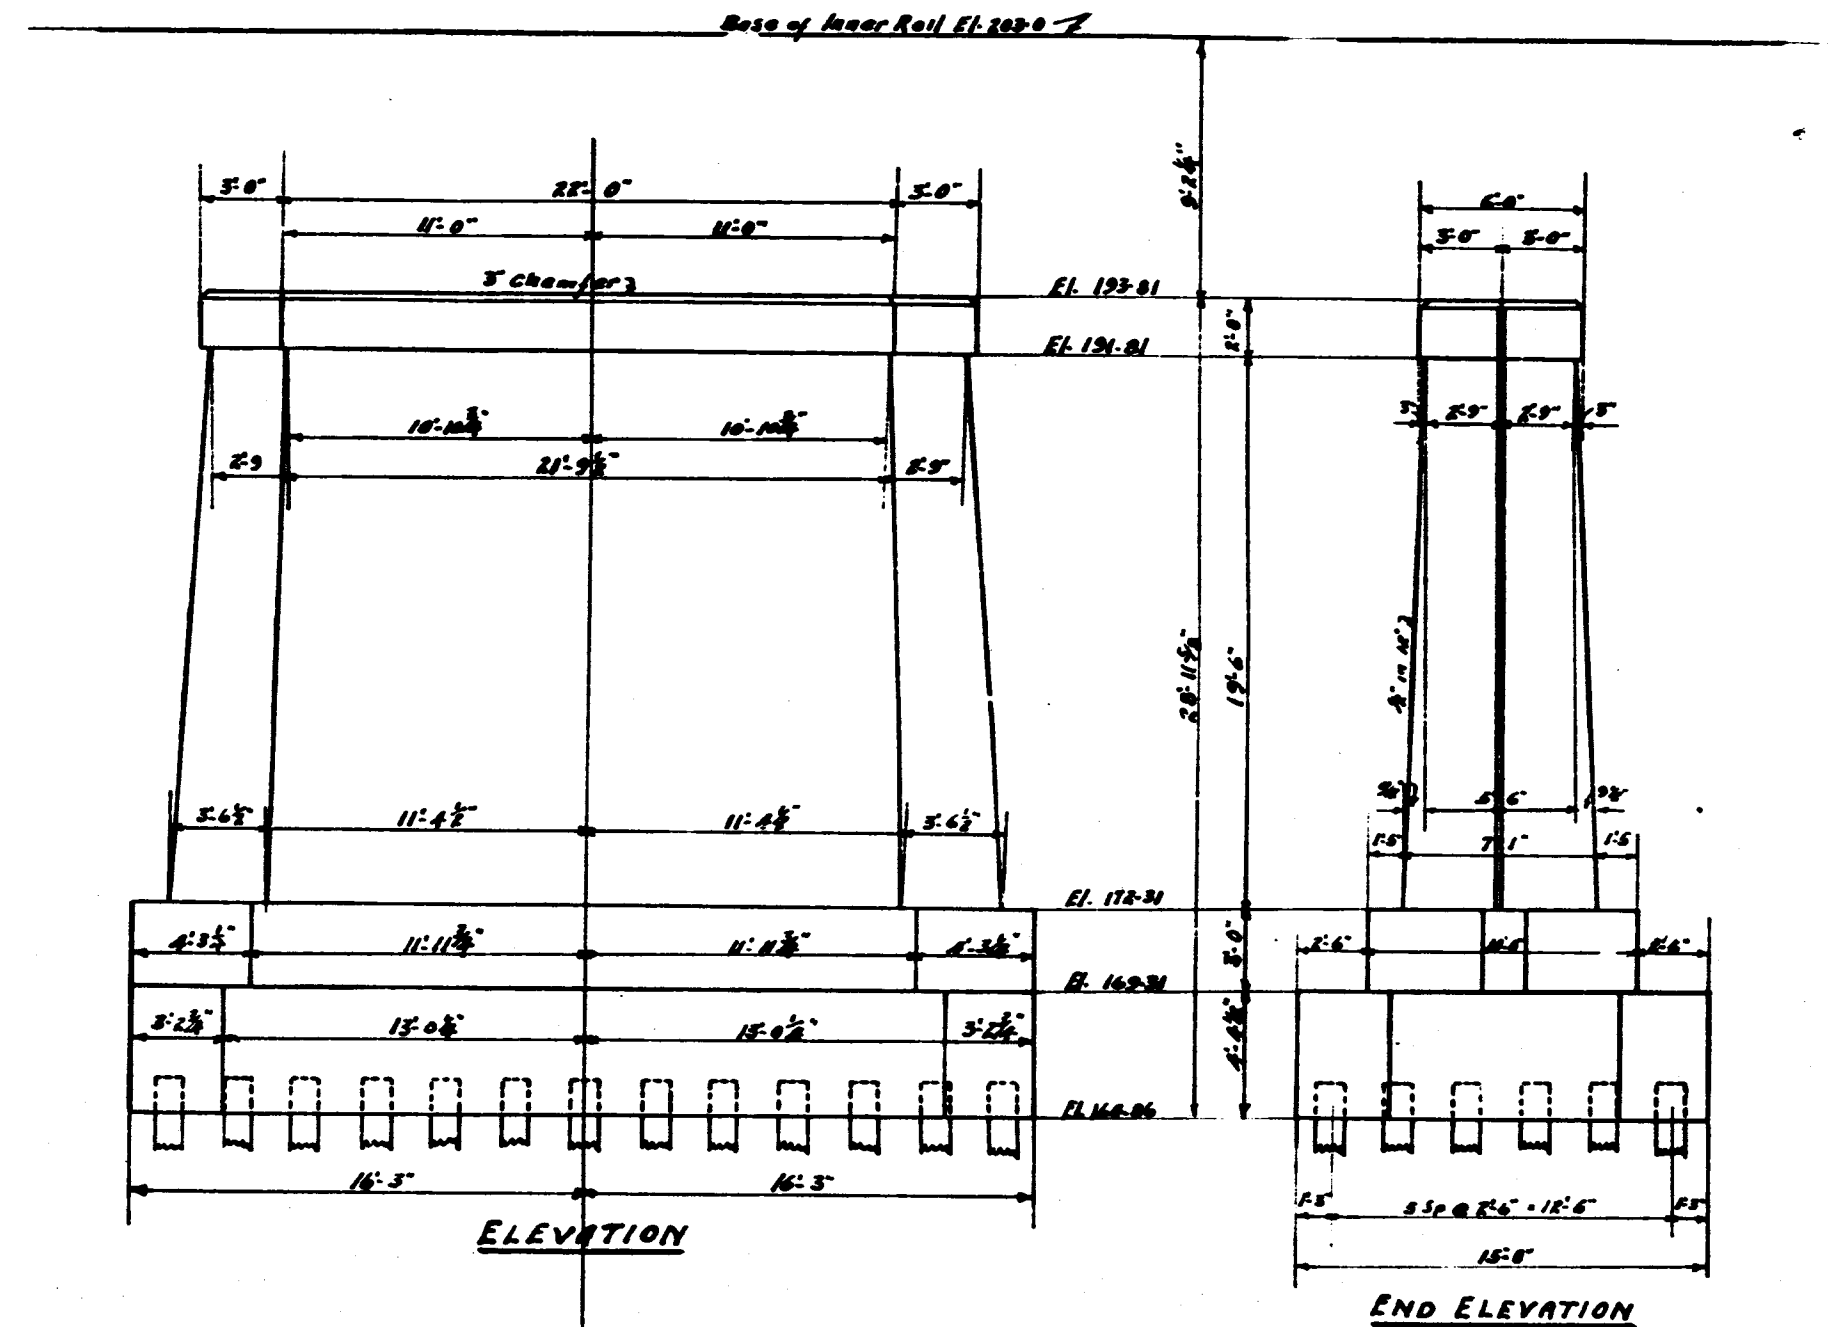

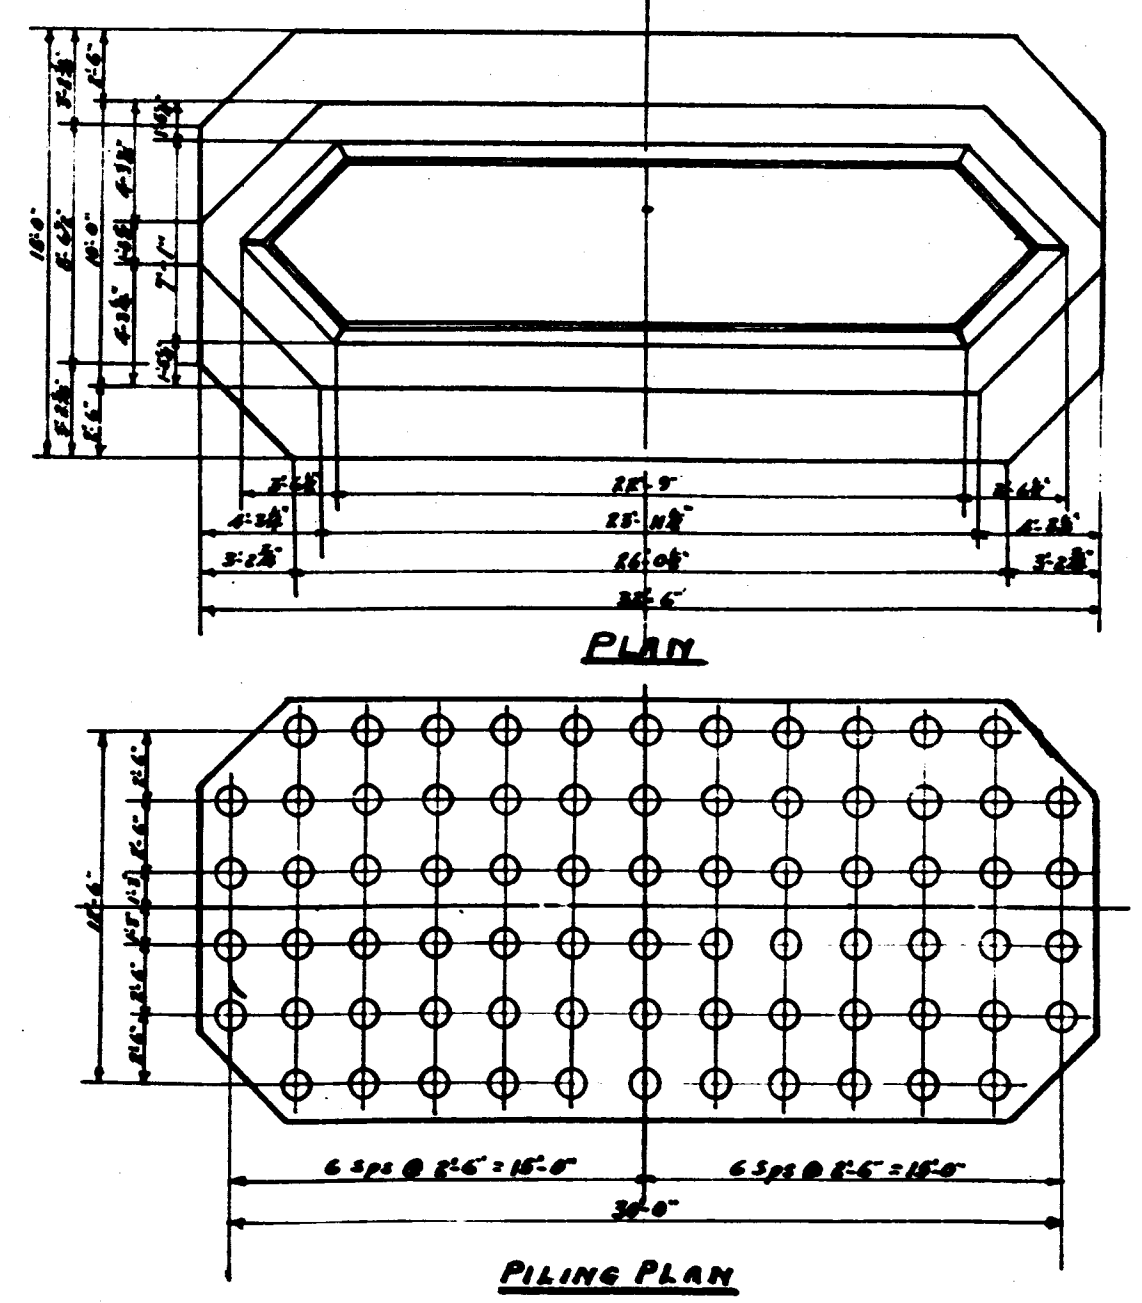

PIER Nº 2

CONCRETE 233 Cu.YDS

PILES 74

CANADIAN NATIONAL RAILWAYS
WESTERN LINES

B.C. DISTRICT OKANAGAN SUBDIVISION MILE 2.78

SUBJECT SOUTH THOMPSON RIVER CROSSING

LOCATION Kamloops

PROVINCE OF BRIT. COLUMBIA

DETAIL PIERS 1 AND 2 AS CONSTRUCTED

FYLE Nº 300 DRAWING Nº D-300-11a FYLE WITH D-300-9 to 3-5-1

SURVEYED OR DESIGNED BY ---------- DRAWN BY E.A.M. TRACED BY ----------

CHECKED BY ---------- REVISED BY ----------

Scale 3/16 in = 1 Ft

Vancouver B.C. April 23 1927

D-300-11a

E.A. MacKenzie
RESIDENT ENGINEER