


24X

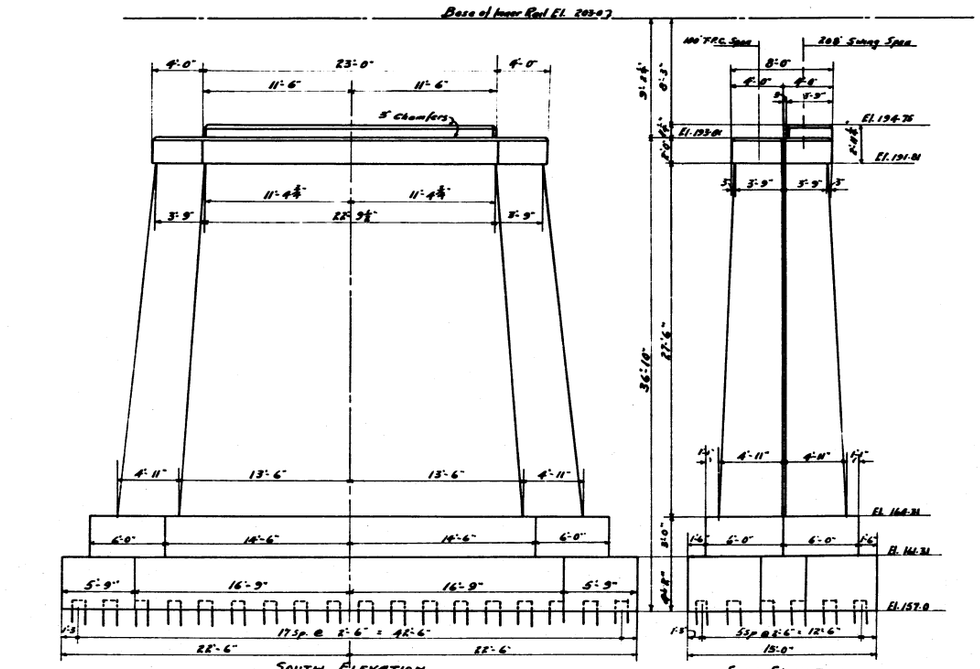

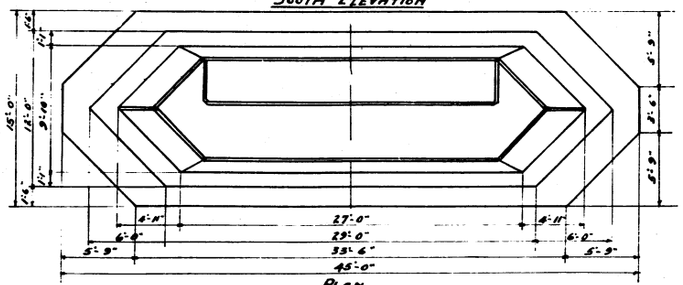

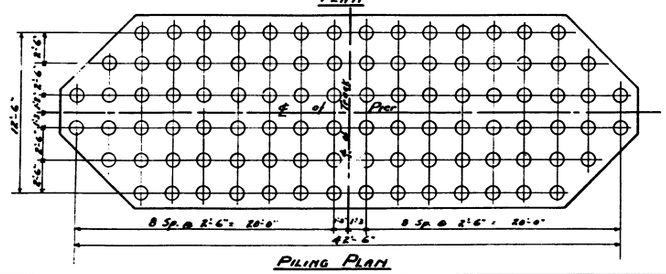

PIER Nº 6

CONCRETE 420 Cu Yds

PILES 96

CANADIAN NATIONAL RAILWAYS
B.C. District OKANAGAN Sub MILE 2.78
Subject South Thompson River Crossing
(As Constructed)
Location Kamloops
Province of B.C.
Details PIERS 6
Tyee No 2000 ... Drawing No D-300-16 Tyee Nos D-300-3 to 3-5-14
Designed by ..... Drawn by ..... Traced by ....
Checked by ..... Revised by .....
Scale 1/8" = 1'-0" Vancouver B.C. March 22/27
D-300-16 9
C.A. Hardinge
Assistant Engineer